

## Designation: PB-2-15

Date Destroyed:

Date Revised:

GPS #:

OCS Index Map: Prado


Page/Grid: N/A

City / Location: Chino Hills

Line #/SSN:

Established By: OCS 2015

Monument Type: Orange County Surveyor's 4"  
Aluminum Disk

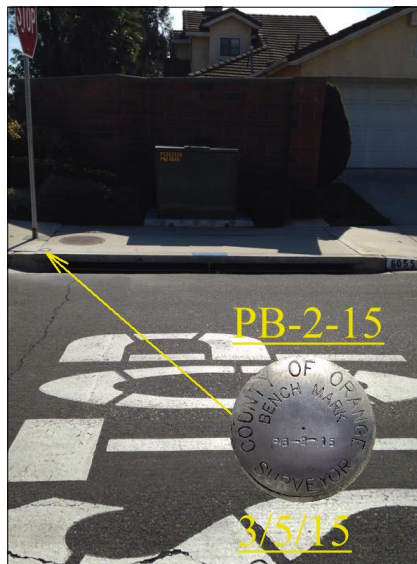


NAVD88 (ft)	NGVD29 (ft)	Year Leveled
633.166	630.803	2015

For Reconnaissance Only!	
Latitude (30' +/-)	Longitude (30' +/-)
33 56 04.54	117 40 22.17

### Description:

DESCRIBED BY OCS 2015 - FOUND 4" OCS ALUMINUM BENCHMARK DISK, STAMPED "PB-2-15", IN NW'LY CORNER OF A 14' X 4' CATCH BASIN, IN S'LY QUADRANT OF THE INTERSECTION OF BUTTERFIELD RANCH ROAD & RIDGEGATE DRIVE. 16' SE'LY OF CENTERLINE OF RIDGEGATE DRIVE, IN FRONT OF ADDRESS 6055 RIDGEGATE DRIVE.

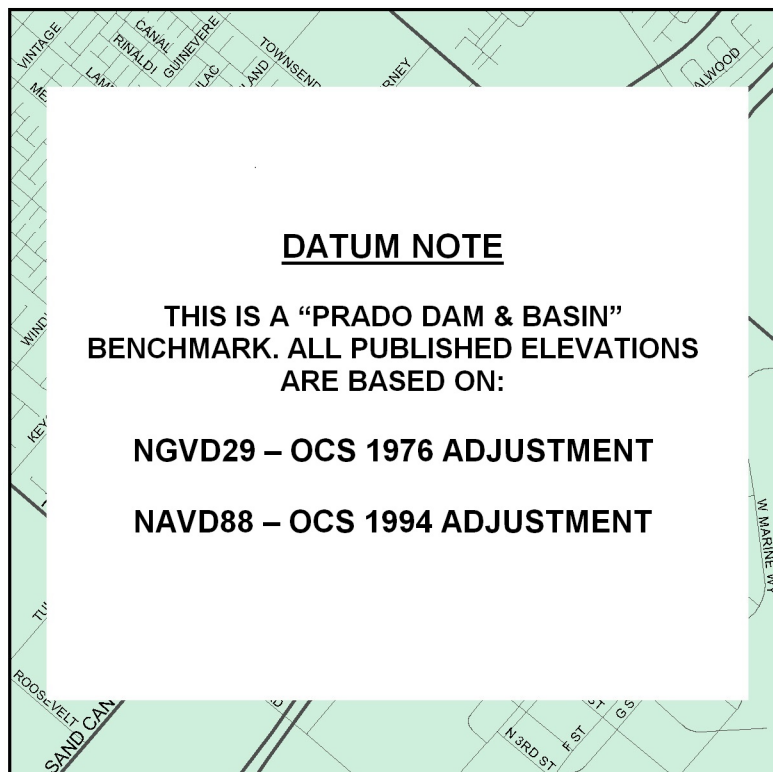

### DATUM NOTE

THIS IS A "PRADO DAM & BASIN" BENCHMARK. ALL PUBLISHED ELEVATIONS ARE BASED ON:

NGVD29 – OCS 1976 ADJUSTMENT

NAVD88 – OCS 1994 ADJUSTMENT