

Designation: PB-27-15

Date Destroyed:

Date Revised:

GPS #:

OCS Index Map: Prado


Page/Grid: N/A

City / Location: Eastvale

Line #/SSN:

Established By: OCS 2015

Monument Type: Orange County Surveyor's 4"
Aluminum Disk

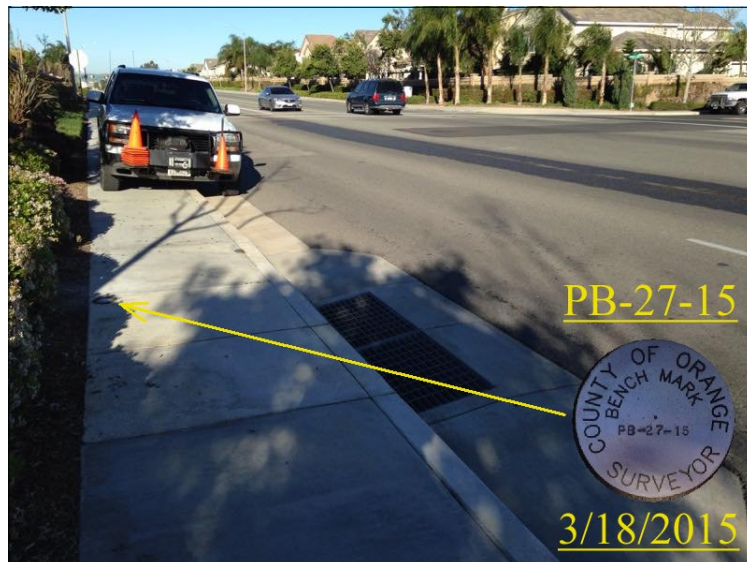

NAVD88 (ft)	NGVD29 (ft)	Year Leveled
584.767	582.396	2015

For Reconnaissance Only!	
Latitude (30' +/-)	Longitude (30' +/-)
33 56 46.33	117 35 19.05

Description:

DESCRIBED BY OCS 2015 - FOUND 4" OCS ALUMINUM DISK, STAMPED "PB-27-15", IN THE SW'LY CORNER OF A 8'X 5' CATCH BASIN, 35' S'LY OF THE CENTERLINE OF CHANDLER STREET, 60' E'LY OF THE INTERSECTION OF CHANDLER STREET & WALNUT GROVE AVENUE.

