

Designation: PB-5-15

Date Destroyed:

Date Revised:

GPS #:

OCS Index Map: Prado

Page/Grid: N/A

City / Location: Chino Hills

Line #/SSN:

Established By: OCS 2015

Monument Type: Orange County Surveyor's 4"
Aluminum Disk




NAVD88 (ft)	NGVD29 (ft)	Year Leveled
577.937	575.574	2015

For Reconnaissance Only!	
Latitude (30' +/-)	Longitude (30' +/-)
33 57 06.68	117 40 58.25

Description:

DESCRIBED BY OCS 2015 - FOUND 4" OCS ALUMINUM BENCHMARK DISK, STAMPED "PB-5-15", IN SE'LY CORNER OF A 11' X 4' CATCH BASIN, 60' E'LY OF THE CENTERLINE OF BUTTERFIELD RANCH ROAD & 50' S'LY OF A DRIVEWAY ENTRANCE TO A FLOOD CONTROL CHANNEL.

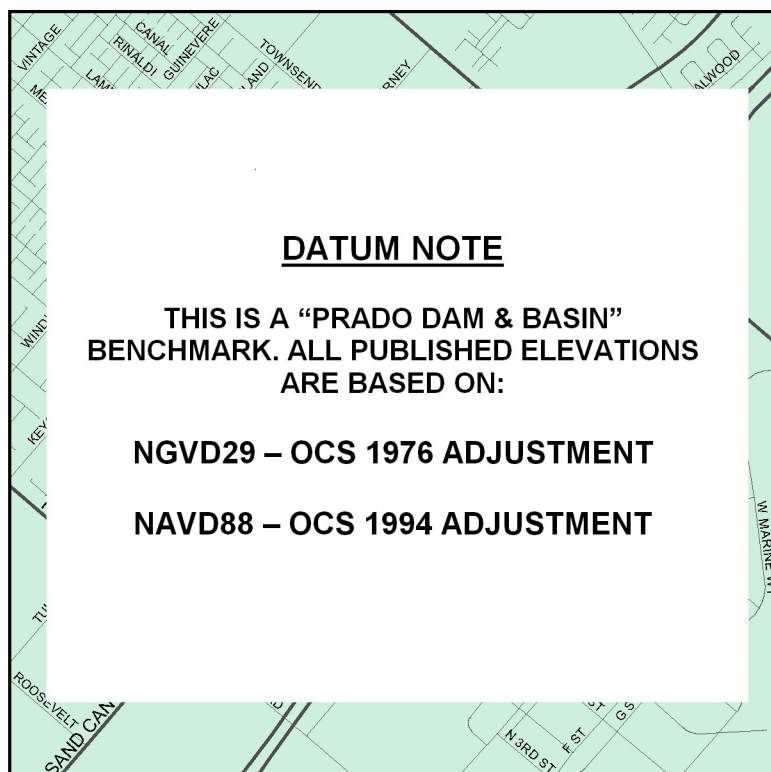

DATUM NOTE

THIS IS A "PRADO DAM & BASIN" BENCHMARK. ALL PUBLISHED ELEVATIONS ARE BASED ON:

NGVD29 – OCS 1976 ADJUSTMENT

NAVD88 – OCS 1994 ADJUSTMENT