




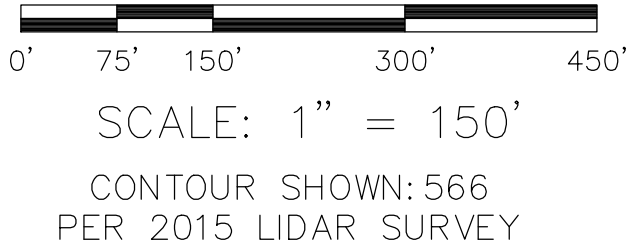


HORIZONTAL DATUM
COORDINATES ARE BASED ON THE CALIFORNIA
COORDINATE SYSTEM (CCS83), ZONE VI, 2007.00 EPOCH,
1983 NORTH AMERICAN DATUM


VERTICAL DATUM
NGVD 1929 (O.C.S. 1995 ADJUSTMENT)

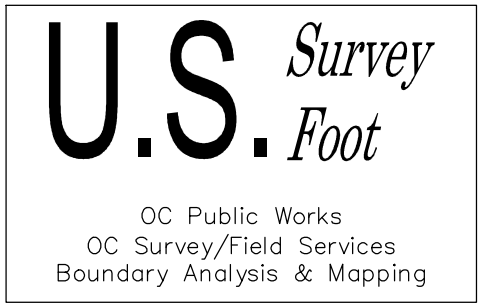


				COUNTY OF ORANGE OC PUBLIC WORKS OC SURVEY/FIELD SERVICES/BOUNDARY ANALYSIS & MAPPING		
				SCE SUBTRANSMISSION PHASE 3A MIRA LOMA-CLEARGEN LINES (66kV)		
				TOPOGRAPHIC MAP		
				PROJECT LIMITS:FROM: BLUFF ST		
				TO: ARCHIBALD AVE		
		DATE OF SURVEY:1/12/2022		BY:REED AND PARTY	SHEET NO. 1 of 2	
		MAPPING		BY:J. MORENO, PLS		
		OFFICE CHECK		BY:J. MORENO, PLS		
		FIELD CHECK		BY:		
		SCALE:1"=150'		W.O. #ESP3009		
				FILE #		
				FILE:PHASE_3A SCE SUBTRANSMISSION_PRELIMINARY.DWG		
MARK	DATE	ITEM				
		REVISIONS				

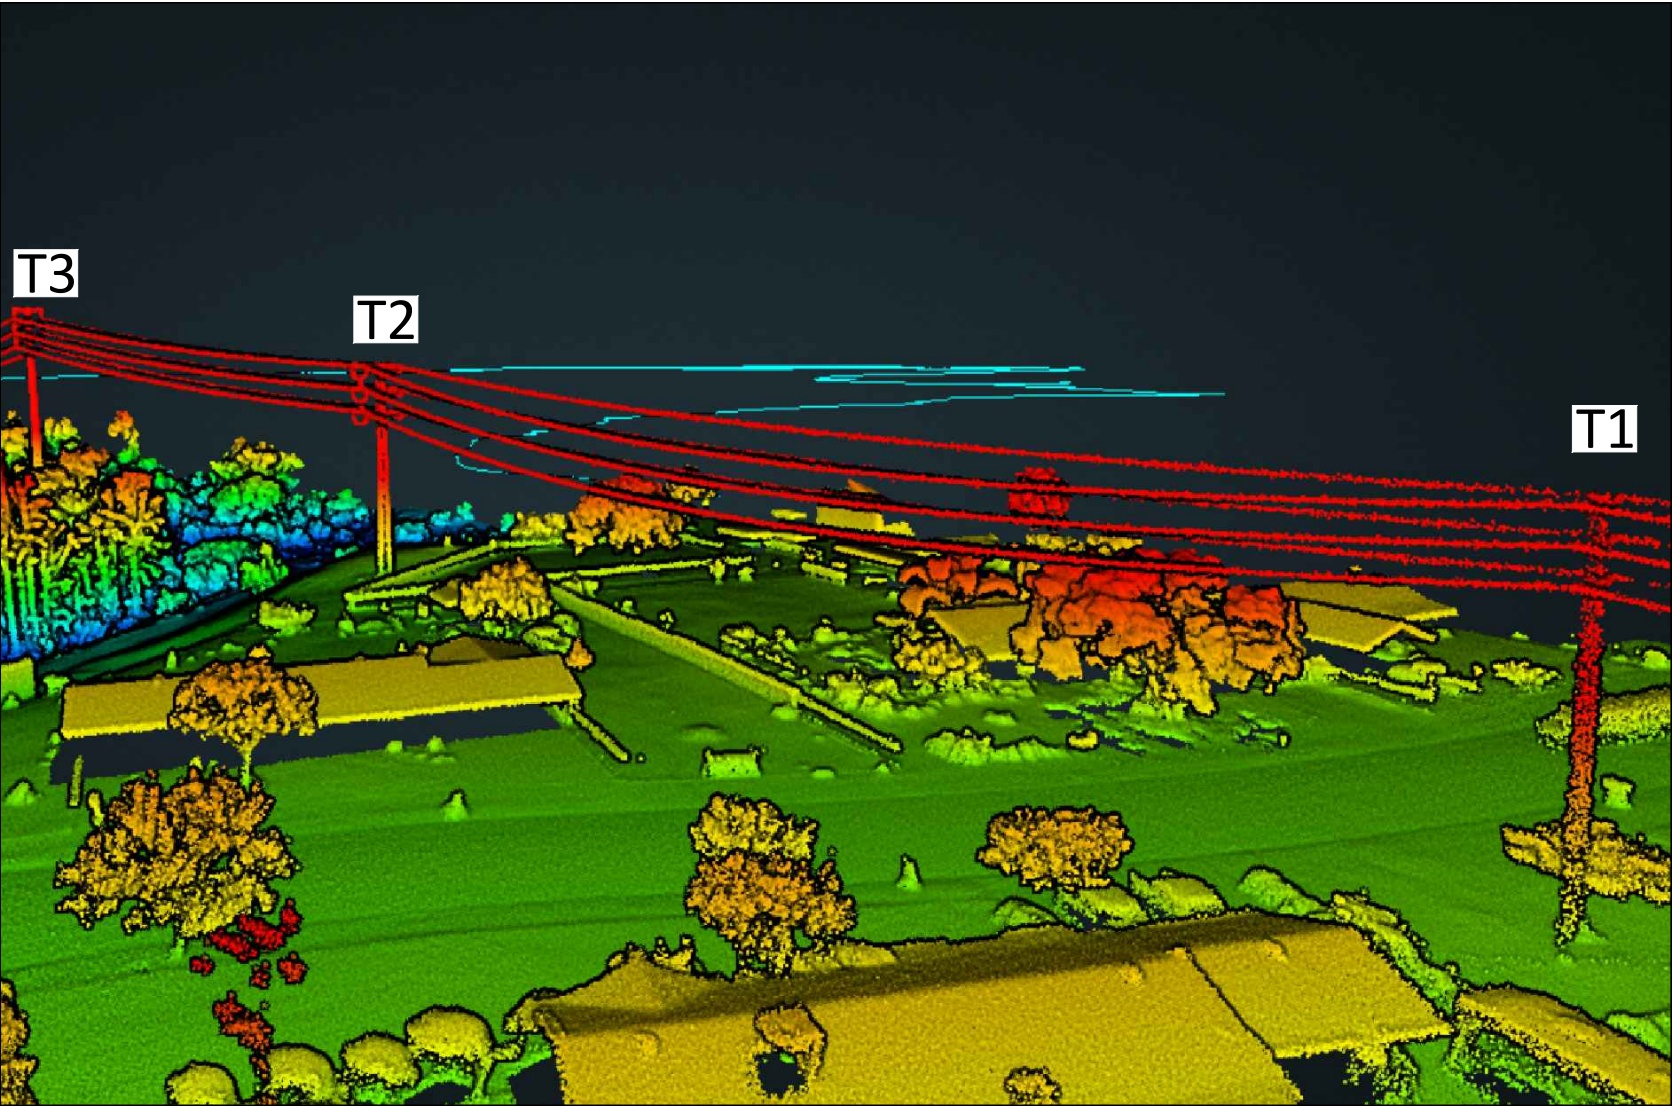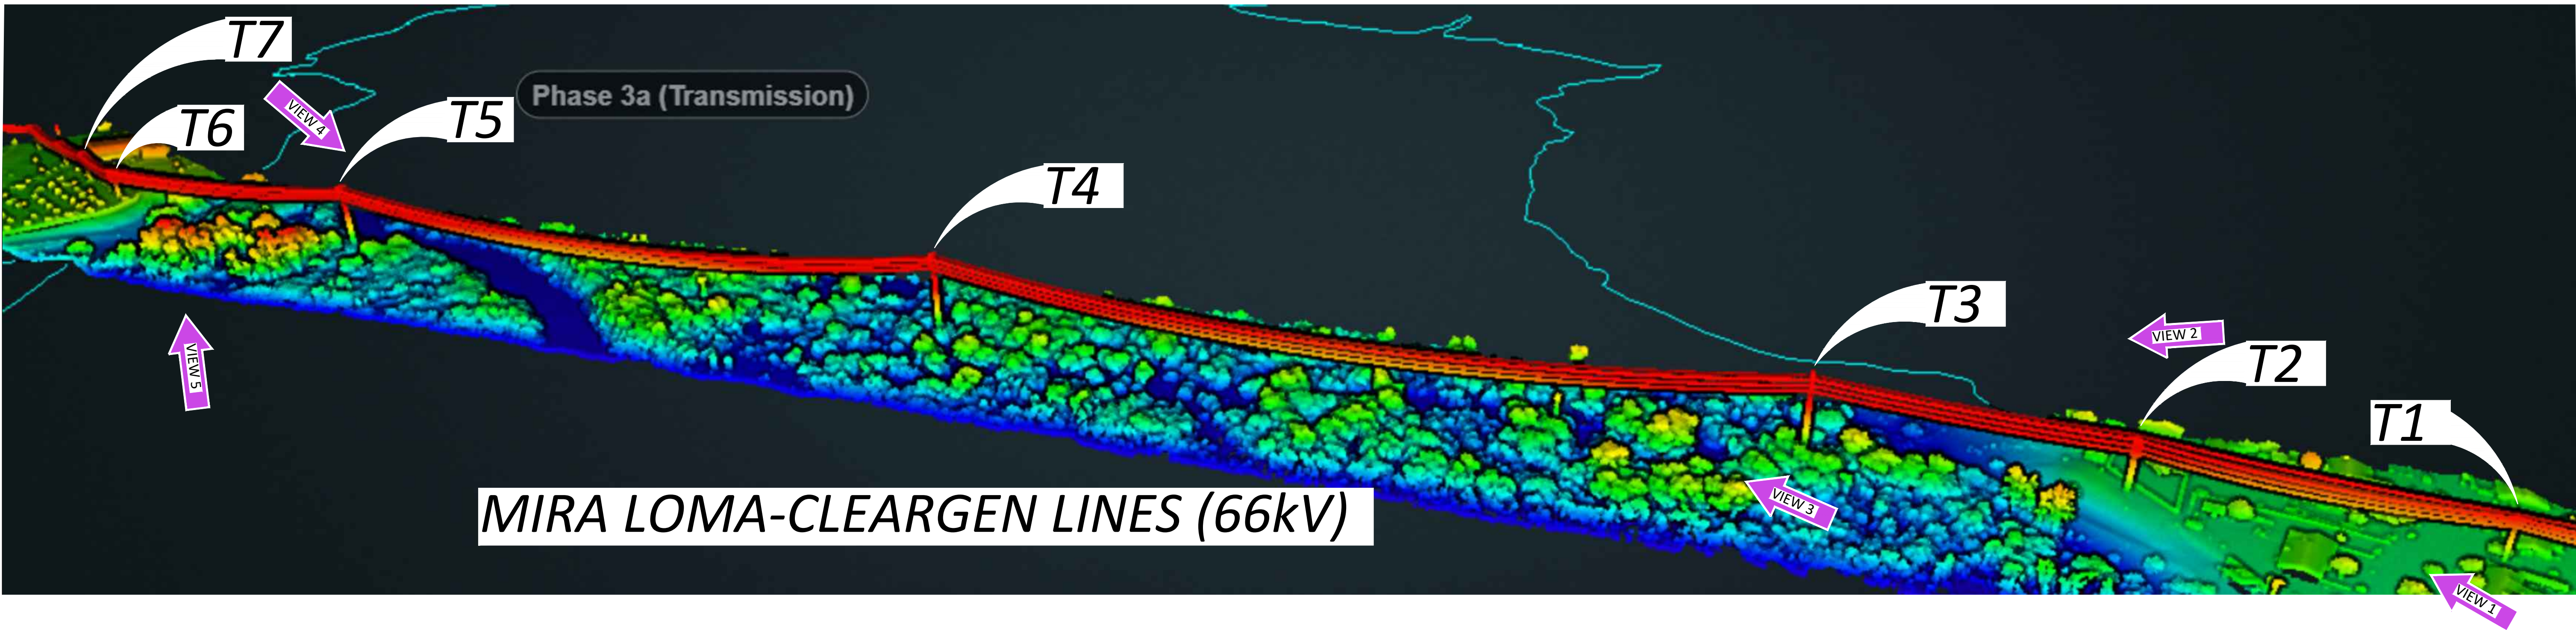


VIEW 1

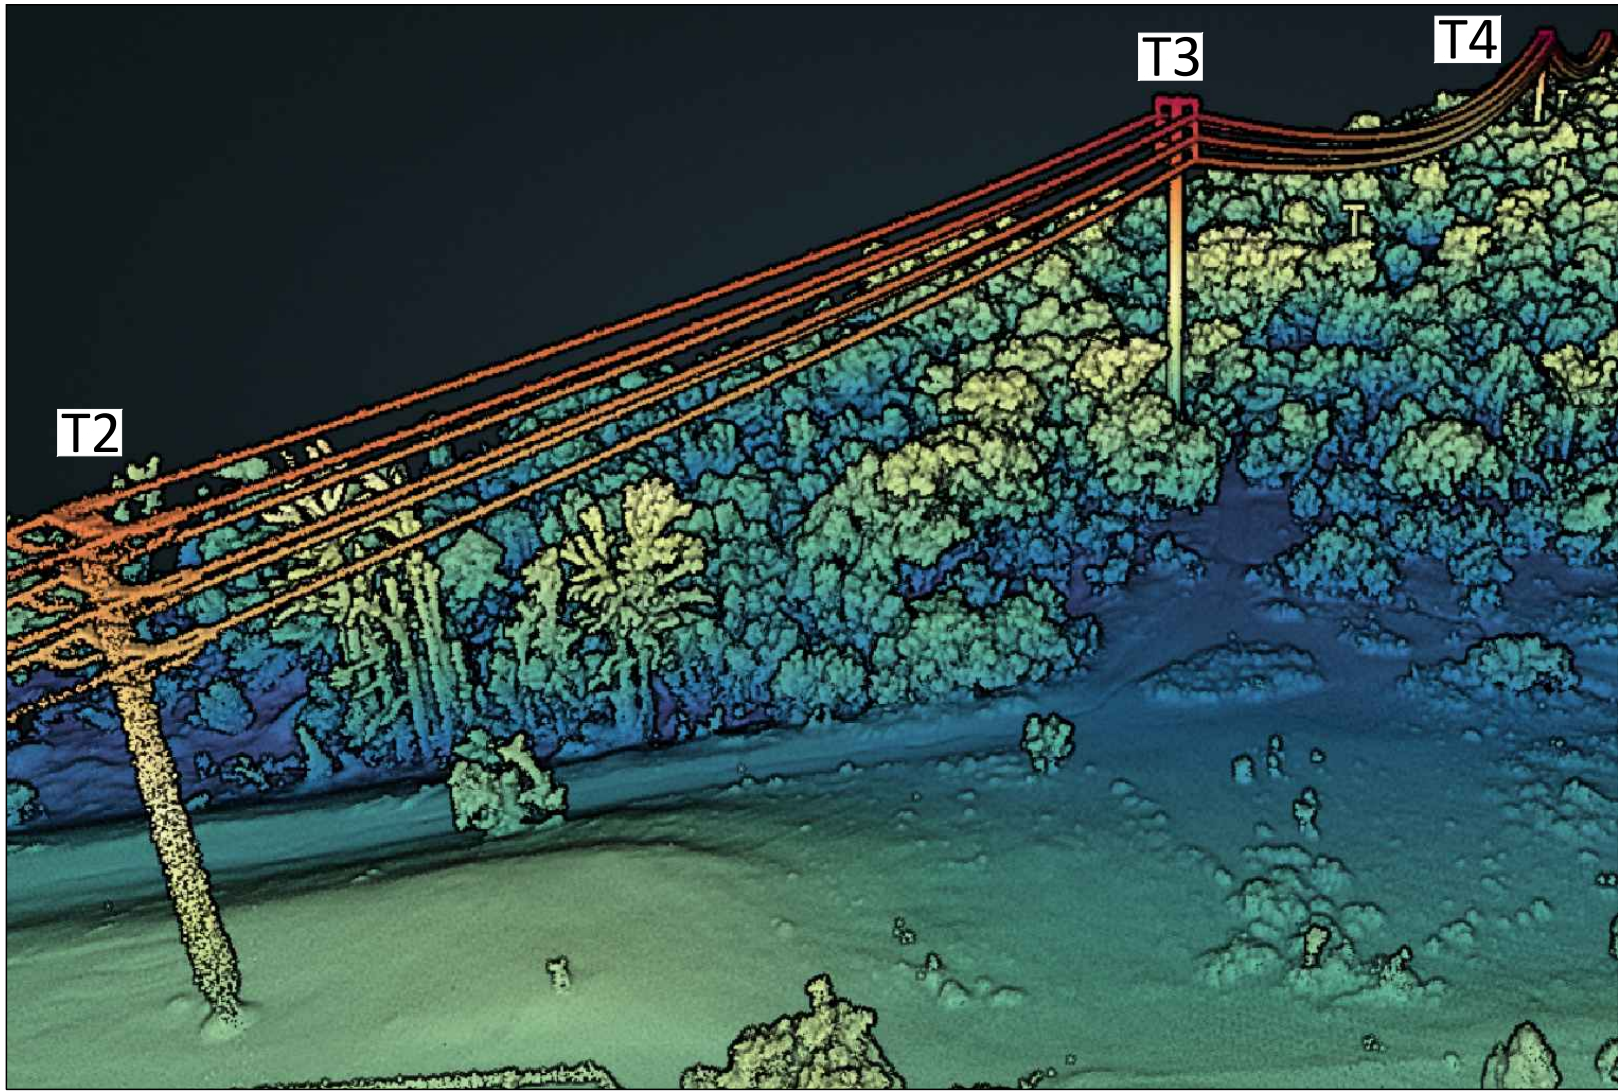


VIEW 2

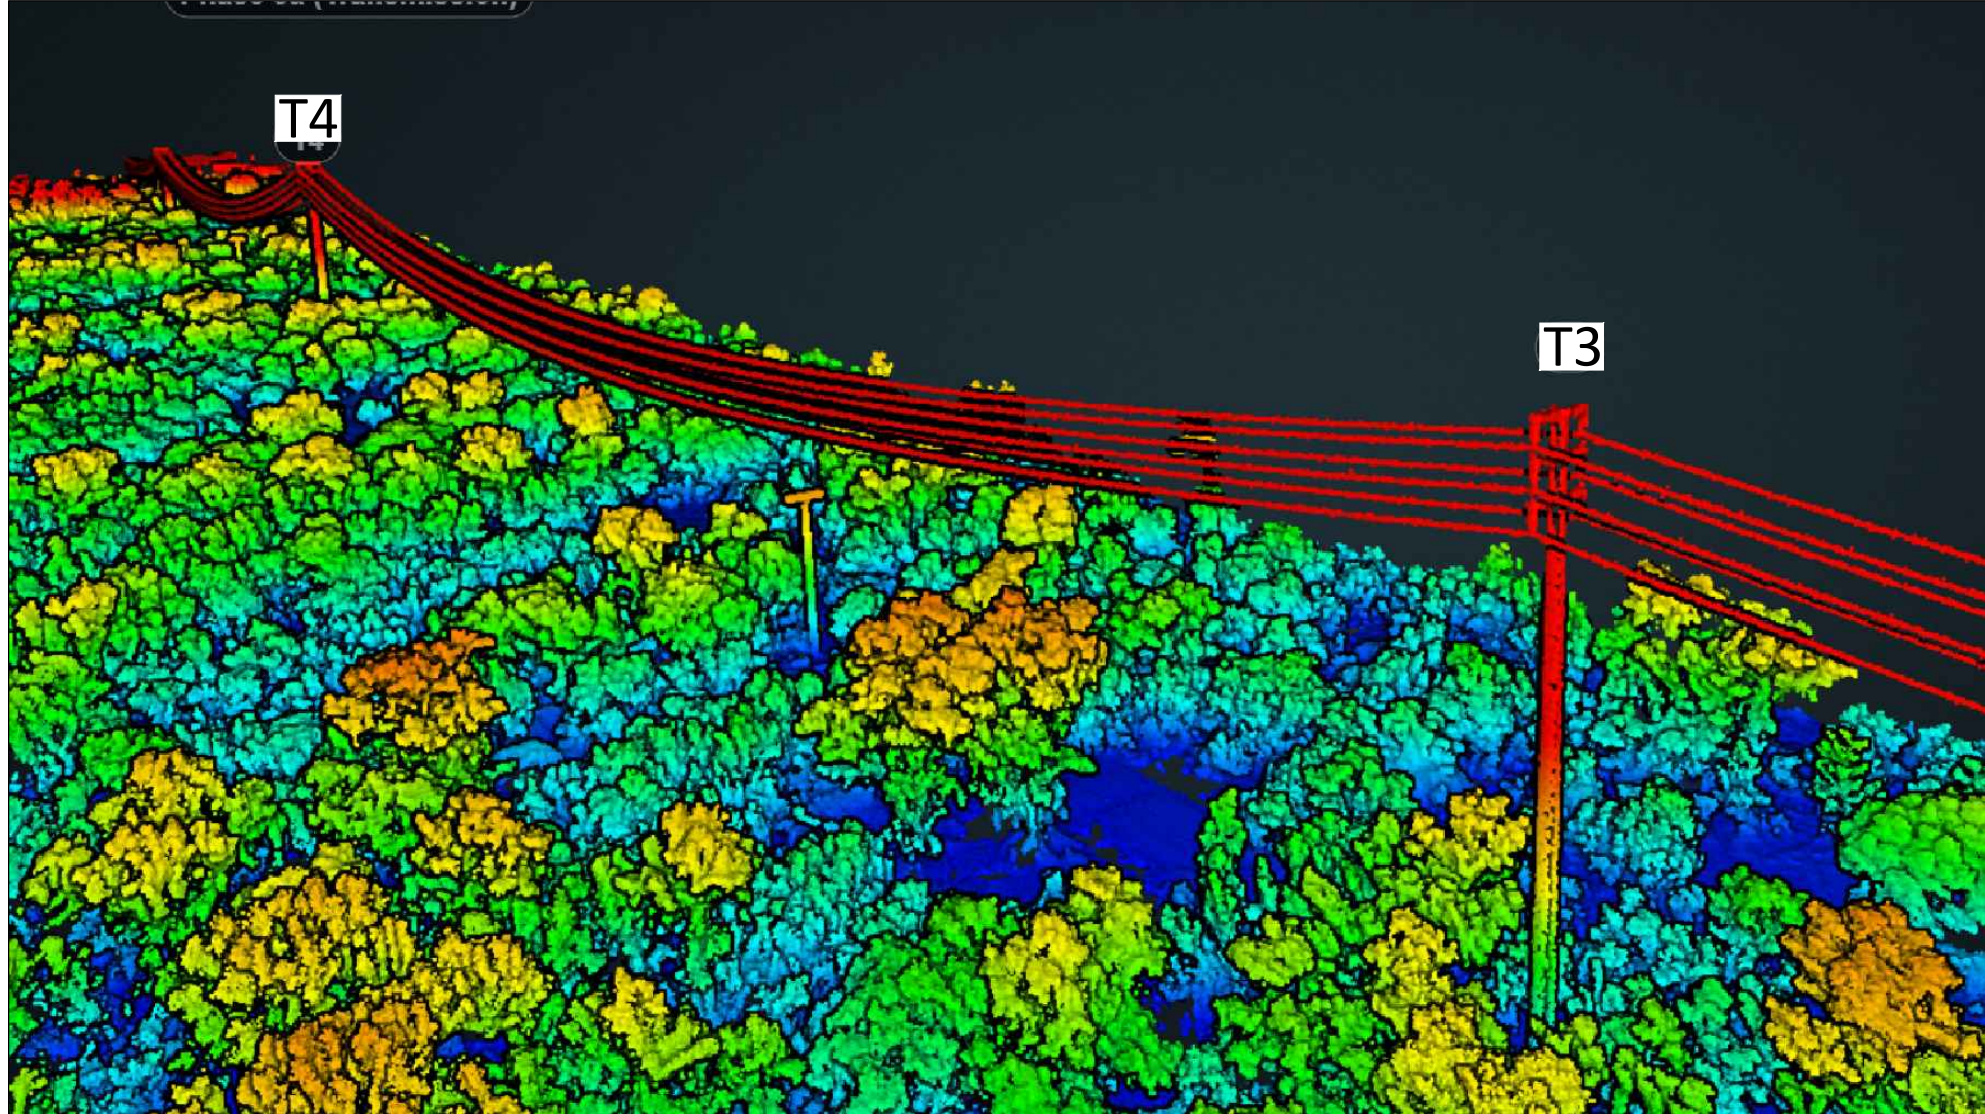

VIEW 3

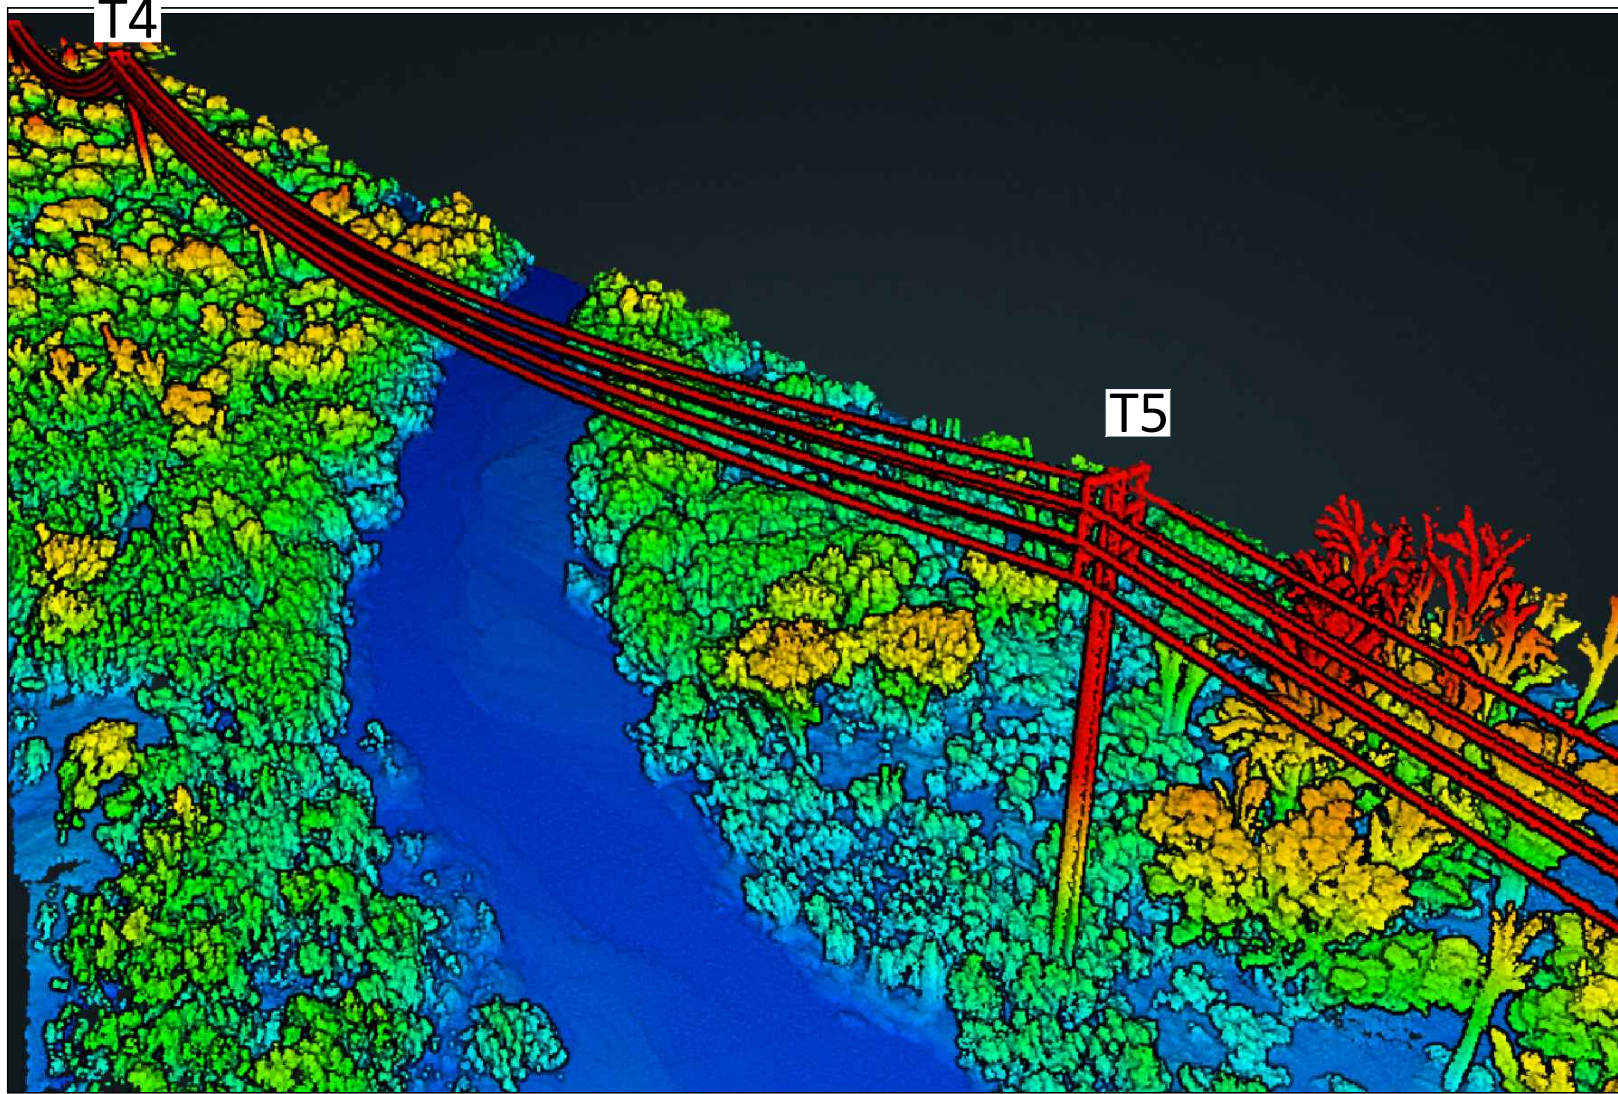



VIEW 4

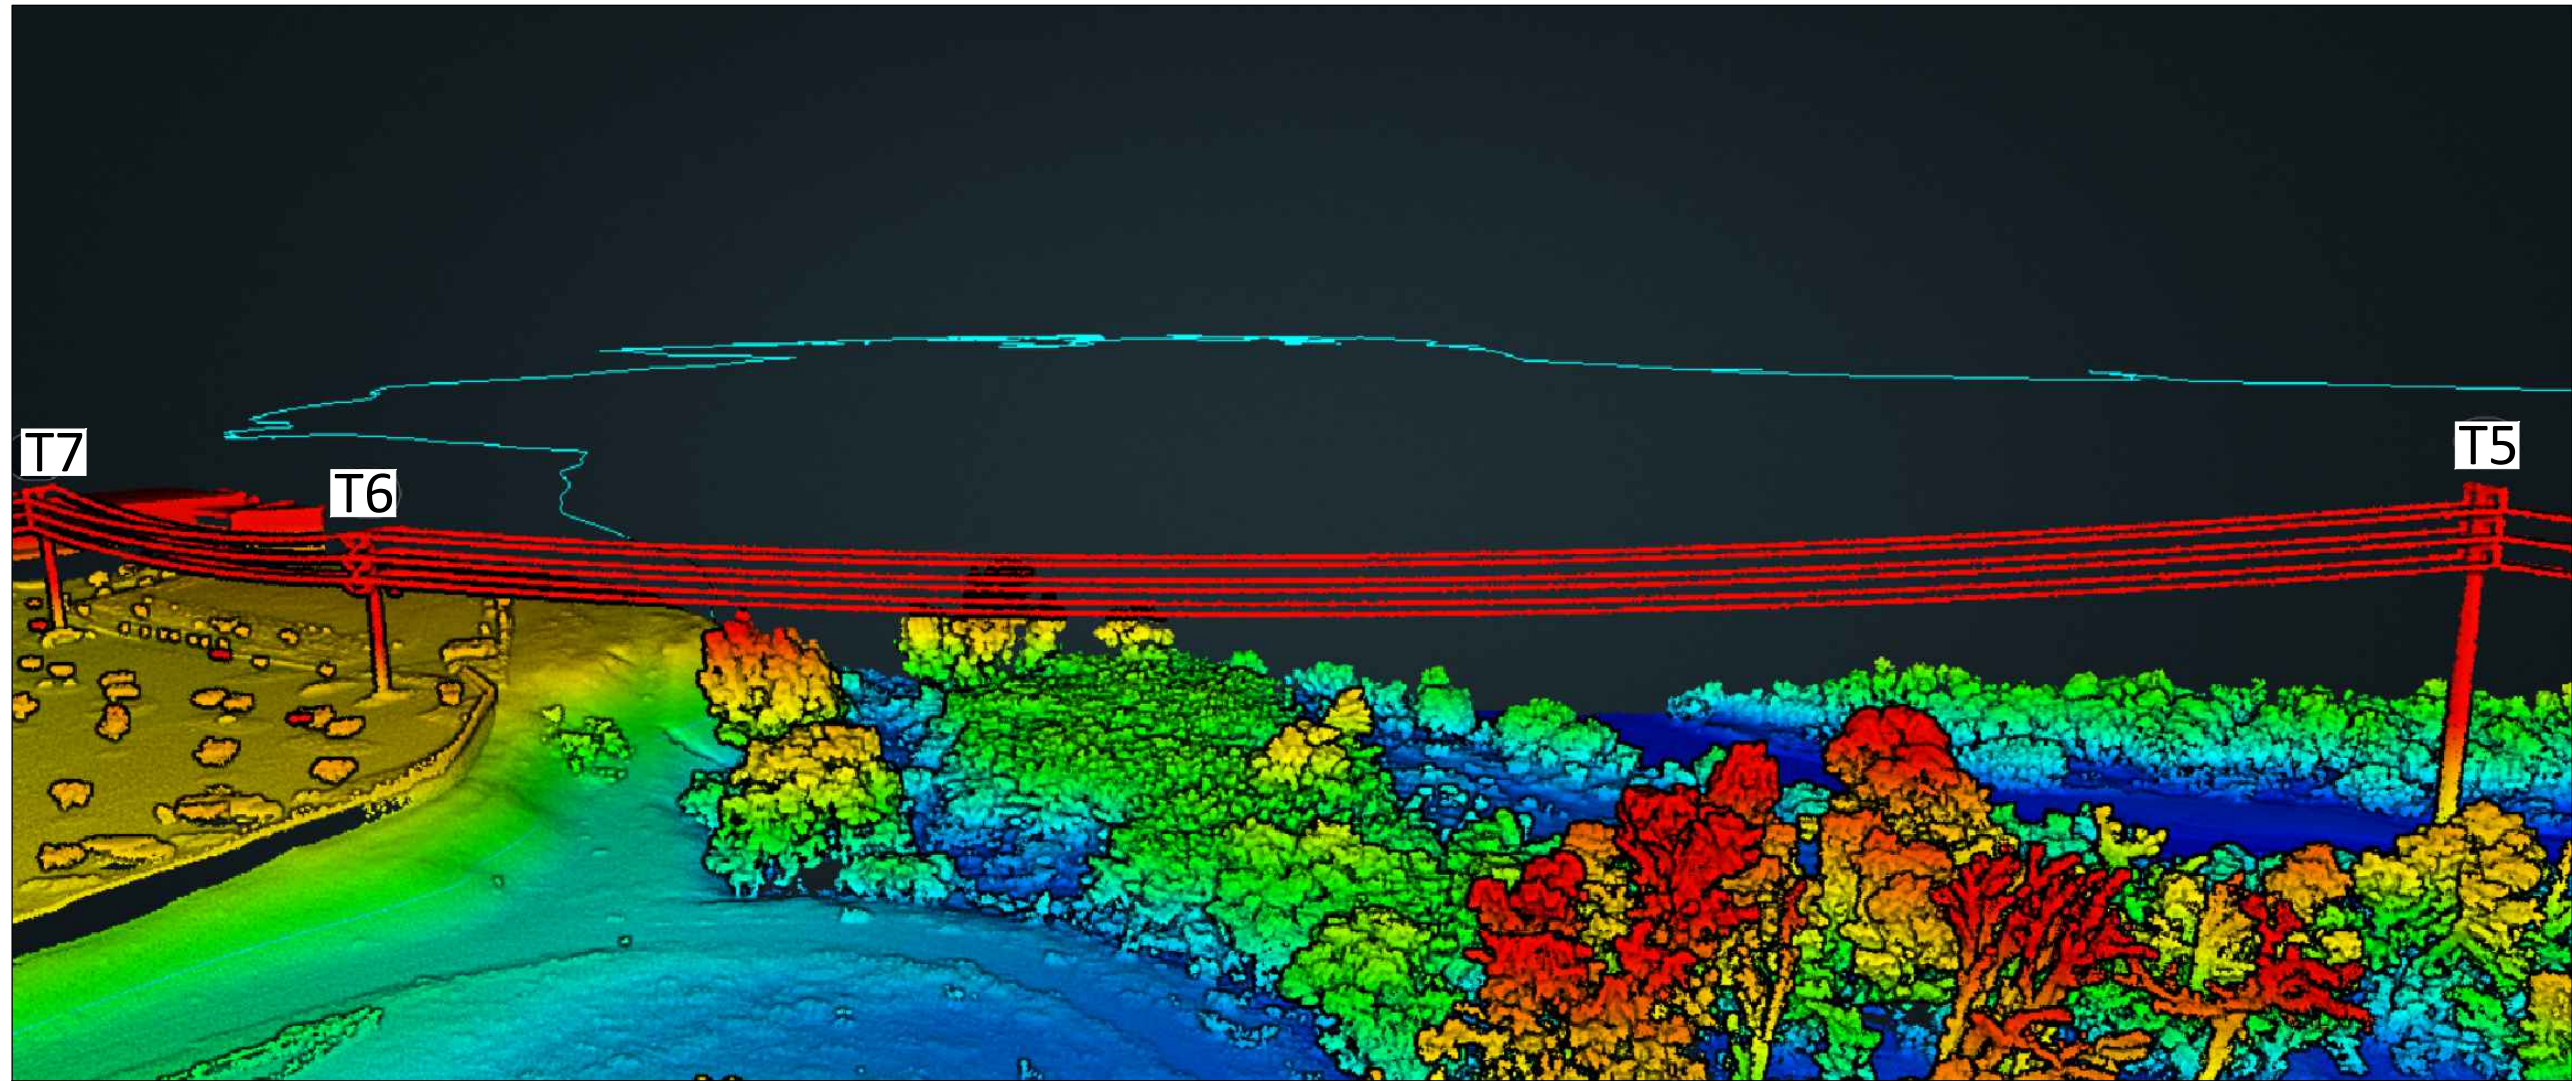

VIEW 5


			COUNTY OF ORANGE OC PUBLIC WORKS OC SURVEY/FIELD SERVICES/BOUNDARY ANALYSIS & MAPPING					
			SCE SUBTRANSMISSION PHASE 3A MIRA LOMA-CLEARGEN LINES (66kV)					
			POINT CLOUD IMAGES					
			PROJECT LIMITS: FROM:BLUFF ST					
			TO: ARCHIBALD AVE					
			DATE OF SURVEY:1/12/2022			BY:REED AND PARTY		SHEET NO. 2 of 2
			MAPPING			BY:J. MORENO, PLS		
			OFFICE CHECK			BY:J. MORENO, PLS		
			FIELD CHECK			BY:		
			SCALE:INTS			W.O. #ESP3009		
FILE:PHASE 3A SCE SUBTRANSMISSION_PRELIMINARY.DWG			FILE #					
MARK	DATE	ITEM						
REVISIONS								

MIRA LOMA-CLEARGEN LINES (66 kV)

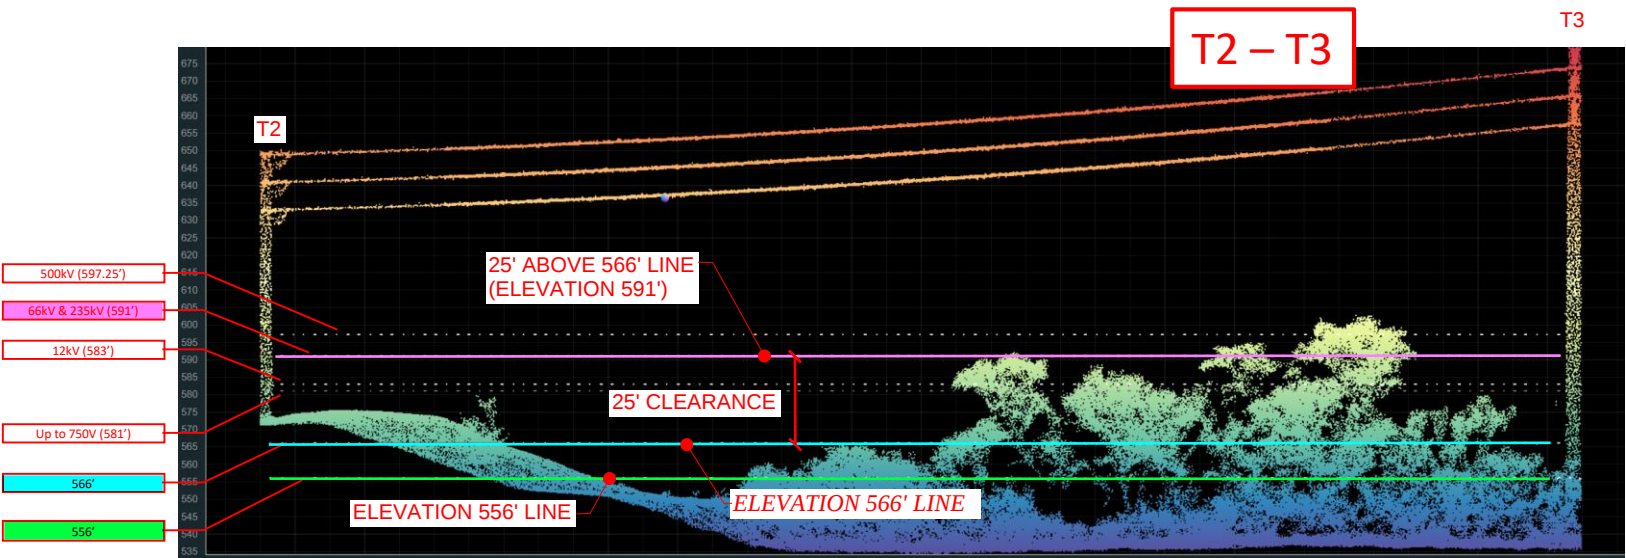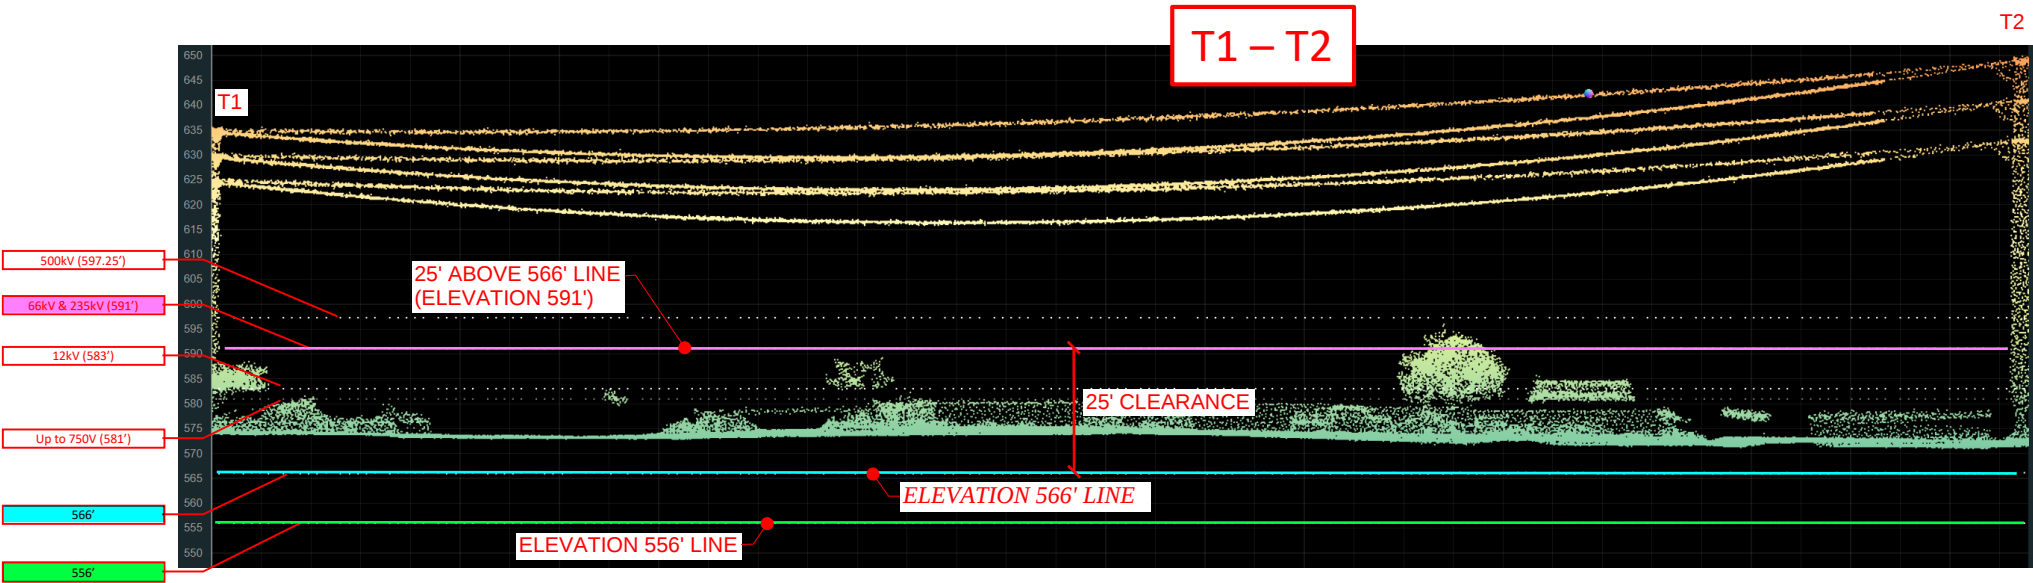


MIRA LOMA-CLEARGEN LINES (66 kV)

T3 – T4

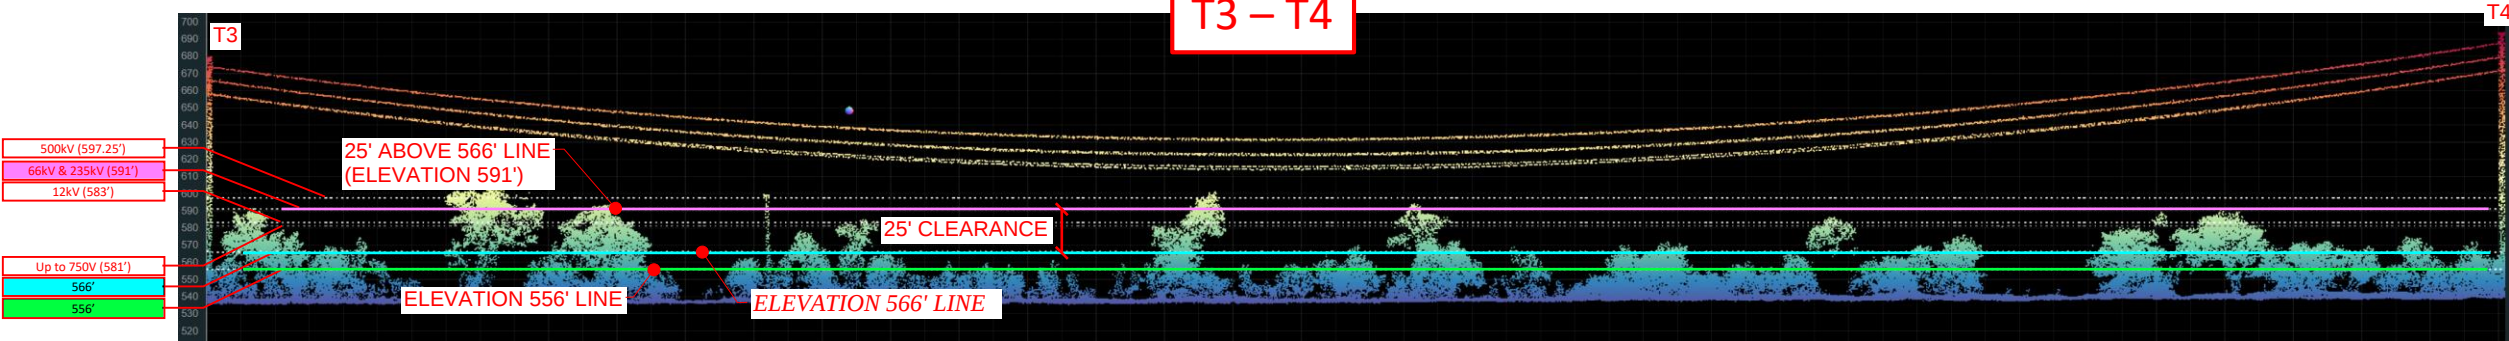


T4 – T5

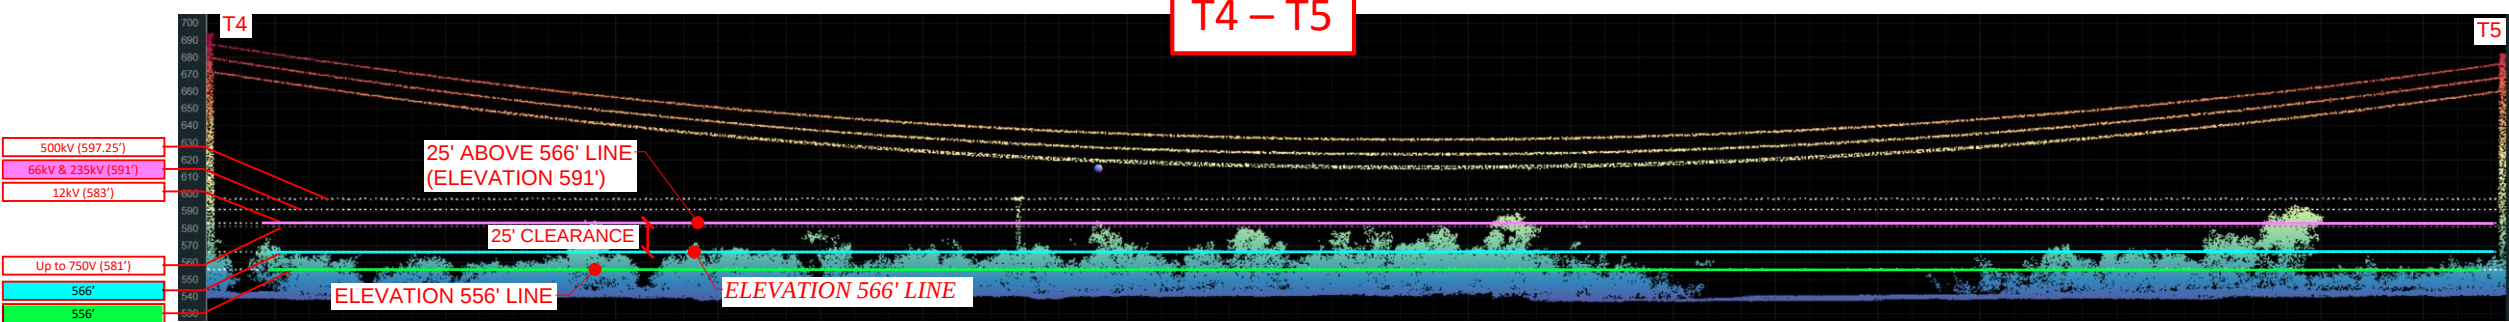

MIRA LOMA-CLEARGEN LINES (66 kV)

T5 – T6

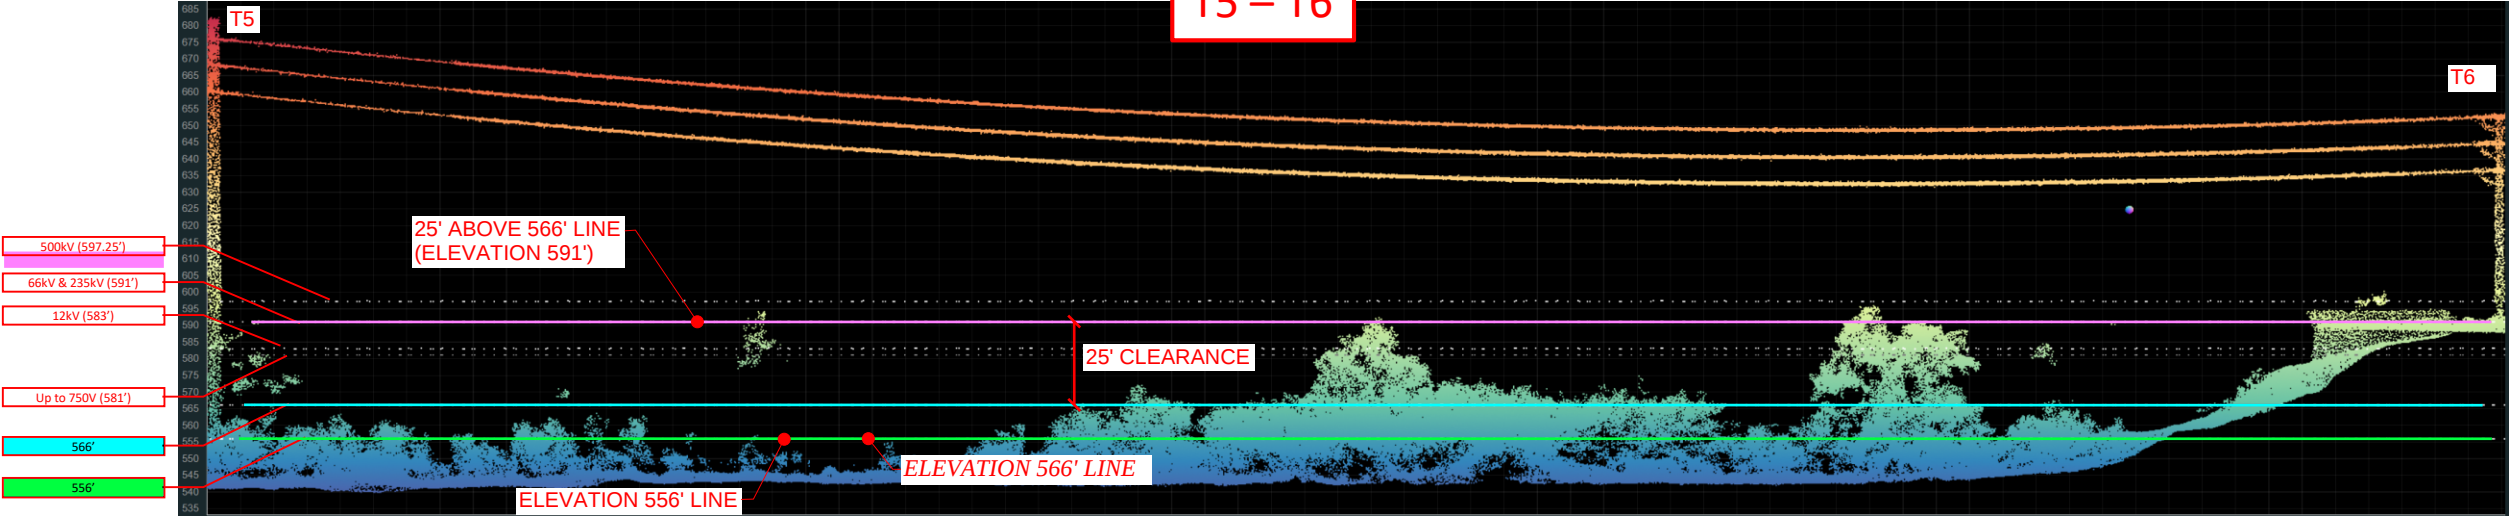

T6 – T7

